



ENVIRONMENT  
AGENCY

**ENVIRONMENTAL PROTECTION ACT 1990.  
WASTE MANAGEMENT LICENCE.**

LICENCE REF No: - EAWML/23718

FACILITY TYPE: - Material Recycling

The Environment Agency, in pursuance of Part II of the Environmental Protection Act 1990, hereby grant a waste management licence authorising the KEEPING and TREATING of controlled waste on the land specified in Schedule 1 to this licence to W H White Plc (Registered No. 957246), White House, Magna Road, Wimborne, Dorset BH21 3AP, the company being in occupation of the said land, the said licence being subject to the conditions specified in Schedule 2 to this licence.

**SCHEDULE 1.- SPECIFIED LAND.**

The licence relates to land at the Site Control Centre, Magna Road, Wimborne, Dorset BH21 3AP, (hereinafter called "the site") shown edged red on Drawing Reference Number 861/108/Bldg B, dated July 2003, and attached to this licence.

Signed

**JULIAN WARDLAW, Team Leader Environment Management (Mid Dorset & Poole)**

Dated 1<sup>st</sup> March 2004

FOR ENVIRONMENT AGENCY OFFICIAL USE ONLY:

**YOUR ATTENTION IS DRAWN TO THE RIGHTS OF APPEAL DETAILED OVERLEAF**

The Environment Agency

Rivers House, Sunrise Business Park, Higher Shaftesbury Road, Blandford Forum DT11 8ST Tel 01258 456080, Fax 01258 455998




THIS DRAWING FORMS PART OF THE WASTE MANAGEMENT LICENCE APPLICATION FOR THE PROPOSED WASTE TREATMENT FACILITY NO 2 AT THE SITE CONTROL CENTRE MAGNA ROAD, WIMBORNE

SIGNED: *[Signature]*  
 DATE: 31 OCTOBER 2003

Legend

A	Construction Area
B	Waste Management Licence Application Area
C	Waste Management Licence Application Area
D	Waste Management Licence Application Area
E	Waste Management Licence Application Area
F	Waste Management Licence Application Area
G	Waste Management Licence Application Area
H	Waste Management Licence Application Area
I	Waste Management Licence Application Area
J	Waste Management Licence Application Area

31392/9

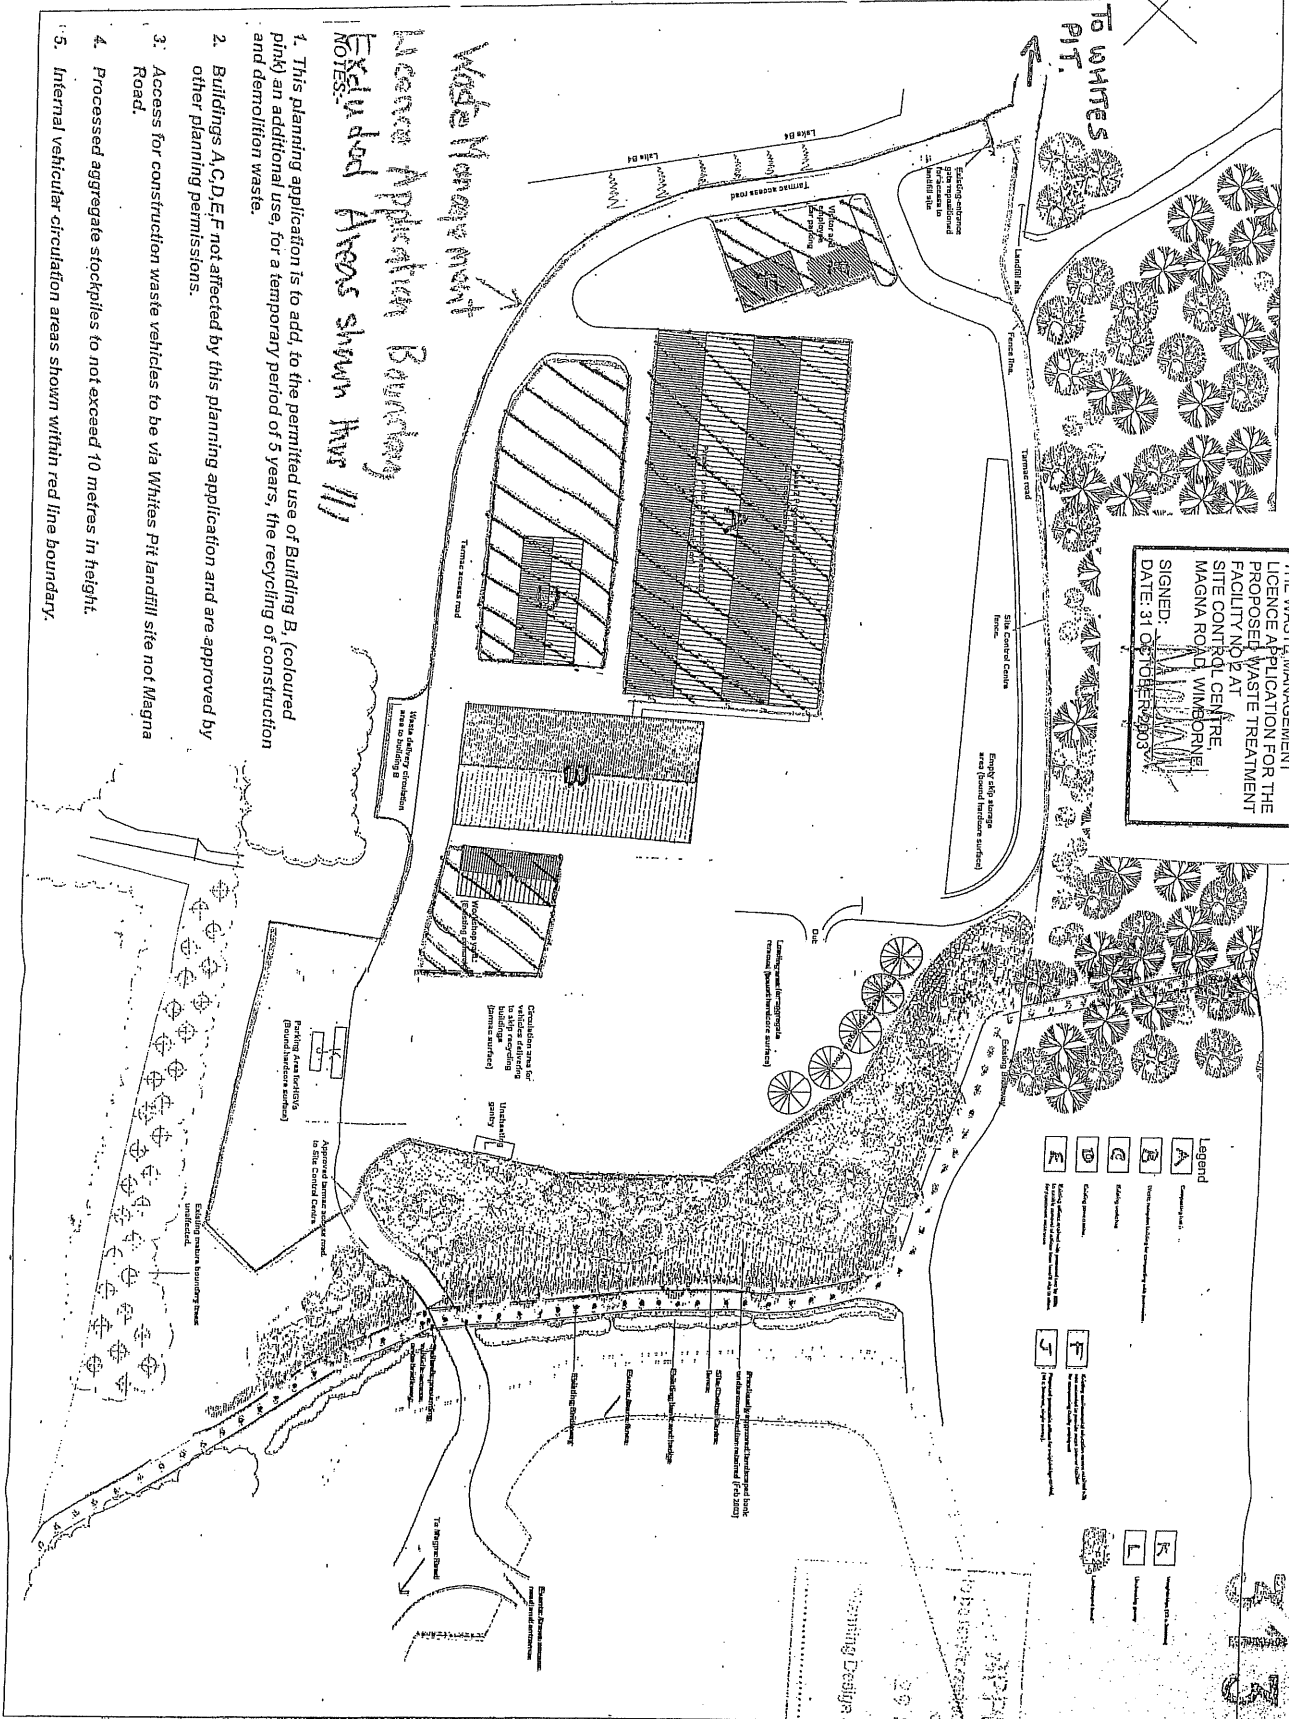


1. This planning application is to add, to the permitted use of Building B, (coloured pink) an additional use, for a temporary period of 5 years, the recycling of construction and demolition waste.
2. Buildings A, C, D, E, F not affected by this planning application and are approved by other planning permissions.
3. Access for construction waste vehicles to be via Whites Pit landfill site Magna Road.
4. Processed aggregate stockpiles to not exceed 10 metres in height.
5. Internal vehicular circulation areas shown within red line boundary.

Waste Management  
 Licence Application Boundary  
 Excluded Areas shown in pink

**Davies Light Associates**  
 Landscape architects & environmental planners

The Long Barn, Bournemouth, Dorset, BH2 9JZ  
 Tel: 01488 557777 Fax: 01488 557777  
 34 Colson, Southampton, Hampshire, SO9 3AA  
 Tel: 01753 940255 Fax: 01753 940253

Client: W R White plc  
 Project: Relocation of recycling facilities to site control centre from landfill site  
 Drawing Title: Site Layout  
 Scale: 1:1250  
 Date: 30/03/03  
 Drawing Number: 34/03/03  
 Rev: July 03

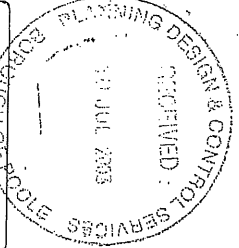

29 SEP 2003  
 Planning Design and Control Services